

LAND SUBDIVISION

COMMERICAL USE

"IRON HORSE PARK"


LOCATED AT
TAX MAP 2 LOT 151-2 AND 151-4
662 MAIN STREET
FREMONT, NEW HAMPSHIRE

SYMBOLS LEGEND

10 FT CONTOUR	DRILL HOLE
2 FT CONTOUR	IRON PIN OR PIPE
STONE WALL	BOUND
EXISTING DITCH	EXISTING RIP RAP APRON OR SWALE
WETLAND	EXISTING UTILITIES
TEST PIT	EXISTING WATER LINE
PERC TEST	EXISTING SPOT ELEVATION
OVERHEAD WIRES	EXISTING WELL
BUILDING SETBACK LINE OR BUFFER	FLOW DIRECTION
	POLE MOUNTED LIGHT
	WALL MOUNTED LIGHT

LIST OF DRAWINGS

SHEET TITLE	SHEET NUMBER
COVER SHEET	1
OVERALL SITE PLAN - WITH ABUTTER INFORMATION	2
EXISTING CONDITIONS	3 AND 4
SUBDIVISION PLANS (R.C.R.D.)	5,6,7

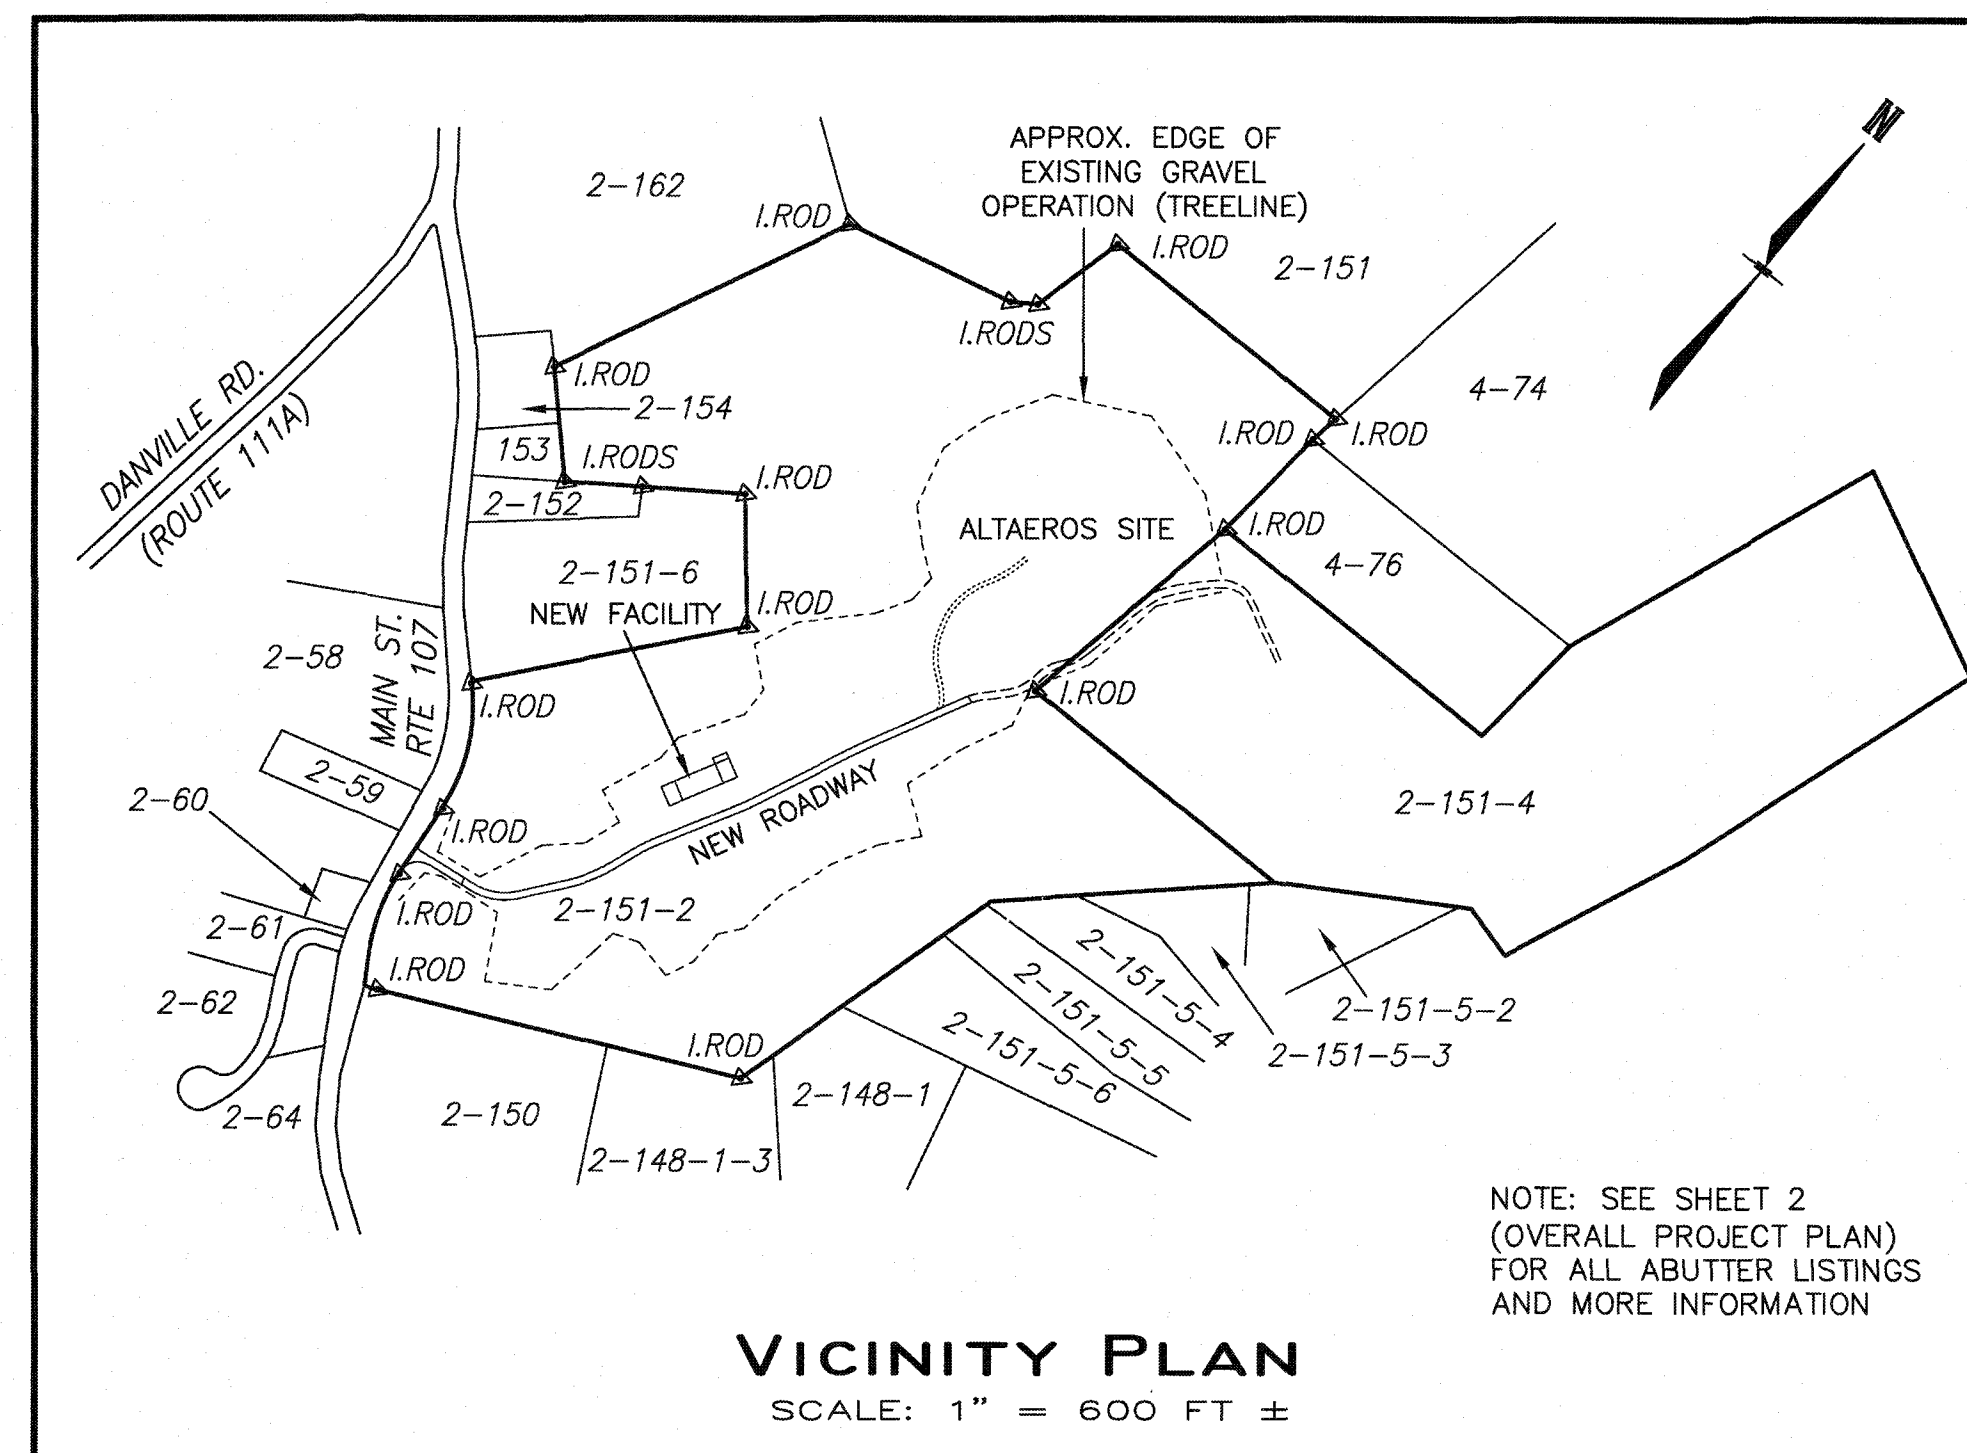

NOTE THE FOLLOWING INFORMATION IS FOR REFERENCE ONLY
AND IS PART OF AN EARLIER TOWN SITE PLAN AND NHDES AND NHDOT AGENCY APPROVALS

PLANNING BOARD WAIVERS

WAIVERS GRANTED ON SEPTEMBER 6, 2017

1. SECTION 1.13 M - PROVIDE PLANS REFLECTING SHAPE, SIZE, HEIGHT AND LOCATION OF EXISTING STRUCTURES LOCATED ON THE SITE AND WITHIN TWO HUNDRED FEET OF THE SITE
2. SECTION 1.13 T-6 - PROVIDE TRAFFIC IMPACT ANALYSIS

WAIVERS GRANTED ON NOVEMBER 21, 2018

1. SECTION 1.10.2 PROVIDE PROPOSED SIGN DETAILS - THE APPLICANT IS REQUESTING RELIEF FROM THIS SECTION. THE PREVIOUSLY APPROVED PLANS FOR ALTAEROS ENERGIES AND THIS SITE PLAN SHOW THE PROPOSED LOCATION OF THE SIGNS. THE SIGNS WILL BE DESIGNED IN ACCORDANCE WITH THE CURRENT FREMONT ZONING SIGN ORDINANCE.
2. SECTION 1.13-E.2 THE LOCATION, SIZE AND DESIGN OF PROPOSED SIGNS AND OTHER ADVERTISING OR INSTRUCTIONAL DEVICES - THE APPLICANT IS REQUESTING RELIEF FROM THIS SECTION. THE PREVIOUSLY APPROVED PLANS FOR ALTAEROS ENERGIES AND THIS SITE PLAN SHOW THE PROPOSED LOCATION OF THE SIGNS. THE SIGNS WILL BE DESIGNED IN ACCORDANCE WITH THE CURRENT FREMONT ZONING SIGN ORDINANCE.
3. SECTION 1.15-K SIDEWALKS MUST BE 6" ABOVE GRADE AND HAVE PROTECTIVE CURBING - THE APPLICANT IS ASKING FOR RELIEF FROM THIS SECTION. THE PROPOSED WALKWAYS ARE MINIMAL AND WILL BE PAVED AND AT GRADE SO AS NOT TO IMPEDE ANY DRAINAGE FLOW OR CAUSE FALLS.
4. SECTION 1.15-N.H - LANDSCAPE AREAS IN BROAD EXPANSES OF PAVEMENT - THE APPLICANT IS REQUESTING RELIEF FROM THIS SECTION. THE PROPOSED FACILITY IS LIGHT MANUFACTURING. THE PROPOSED SITE LOCATION IS LOCATED APPROXIMATELY 900 FEET ALONG AN EXISTING DRIVE OFF OF ROUTE 107 AND WILL NOT BE VISIBLE FROM ROUTE 107 OR FROM ANY ABUTTERS. THE BROAD EXPANSES OF PAVEMENT ARE DUE TO TRUCK MOVEMENTS TO AND FROM THE BUILDINGS. LANDSCAPED AREAS WOULD CREATE UNNECESSARY ADDITIONAL PAVEMENT.
5. SECTION 1.15-N.I - 5% LANDSCAPE AREAS IN PARKING AREAS OF 20 SPACES OR MORE - THE APPLICANT IS REQUESTING RELIEF FROM THIS SECTION. THE PROPOSED FACILITY IS LIGHT MANUFACTURING. THE PROPOSED SITE LOCATION IS LOCATED APPROXIMATELY 900 FEET ALONG AN EXISTING DRIVE OFF OF ROUTE 107 AND WILL NOT BE VISIBLE FROM ROUTE 107 OR FROM ANY ABUTTERS. THE BROAD EXPANSES OF PAVEMENT ARE DUE TO TRUCK MOVEMENTS TO AND FROM THE BUILDINGS. LANDSCAPED AREAS WOULD CREATE UNNECESSARY ADDITIONAL PAVEMENT.

AGENCY APPROVALS:


NHDES - ALTERATION OF TERRAIN APPR # AOT-1594 ON 05-03-2019
NHDES - SUBSURFACE CONSTRUCTION APPR # eCA2019072211 & eCA2019072212
NH HERITAGE INVENTORY DATA CHECK NHB18-2982 (OCT. 2018)
NH FISH AND GAME SPECIES CHECK NHB18-2982 (FEB. 2019)
NHDOT PERMIT 06-167-213 ON 08-16-2019
EPA NOI PERMIT NOI:NHR1000N5 ACTIVE ON 11-28-2018

ZONING VARIANCES:

TWO VARIANCES WERE GRANTED ON SEPTEMBER 25, 2018 FROM THE TERMS OF ARTICLE XI SECTION 1101.3 OF THE TOWN OF FREMONT ZONING ORDINANCE.
(CASE 018-007)
(1) TO PERMIT THE CONSTRUCTION OF A 40 FOOT MANUFACTURING/ASSEMBLY BUILDING
(2) TO PERMIT THE CONSTRUCTION OF A 55 FOOT HIGH MANUFACTURING/ASSEMBLY BUILDING WHERE THE HEIGHT LIMIT IS NORMALLY 35 FEET.

NOTE: A CONDITIONAL USE PERMIT UNDER ZONING ORDINANCE 1203.6.F.2 WAS GRANTED ON DECEMBER 19, 2018

LAND SURVEY PREPARED BY:



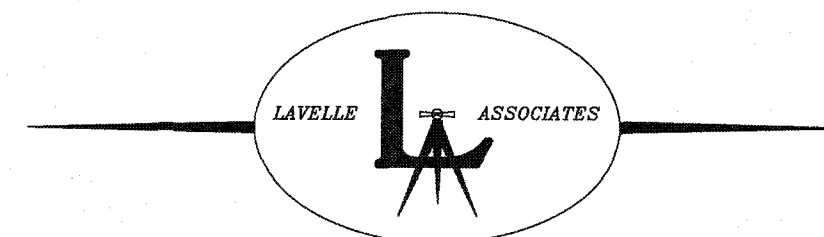


JAMES M. LAVELLE ASSOCIATES
2 STARWOOD DRIVE
HAMPSTEAD, NH 03841
TEL. (603) 329-6851
E-MAIL: INFO@JMLASURVEY.COM

CERTIFIED WETLAND SCIENTIST:

LUKE D. HURLEY (CWS 232)
GOVE ENVIRONMENTAL SERVICES, INC
8 CONTINENTAL DRIVE, EXETER, NH 03833
TEL. (603) 580-4121

WETLAND LOCATIONS WERE PERFORMED AND/OR VERIFIED BY GOVE ENVIRONMENTAL SERVICES, INC. PERFORMED IN LATE 2017

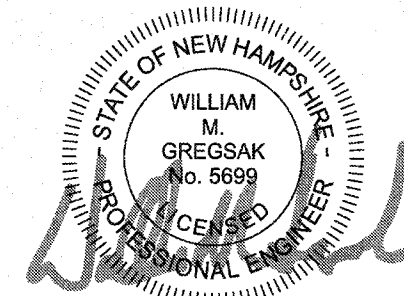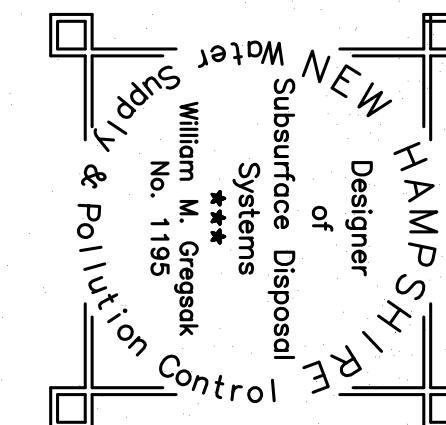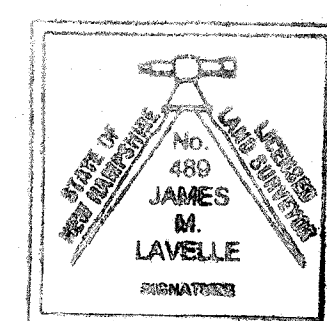

APPROVAL BY THE FREMONT PLANNING BOARD

CHAIRMAN	DATE
SECRETARY	DATE

REVISIONS

NO.	DESCRIPTION	DATE

JULY 12, 2022


OWNER:

FREMONT LAND, LLC
453 NH ROUTE 125
BRENTWOOD, NH 03833

APPLICANT:


FREMONT LAND, LLC
453 NH ROUTE 125
BRENTWOOD, NH 03833

GREGSAK & SONS, INC.

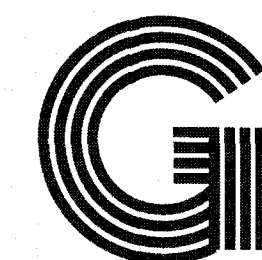

ENGINEERING, ARCHITECTURE
& CONSTRUCTION MANAGEMENT

P.O. BOX 271
CHESTER, NEW HAMPSHIRE 03036
PH: (603) 887-6979
WWW.GREGSAK.COM

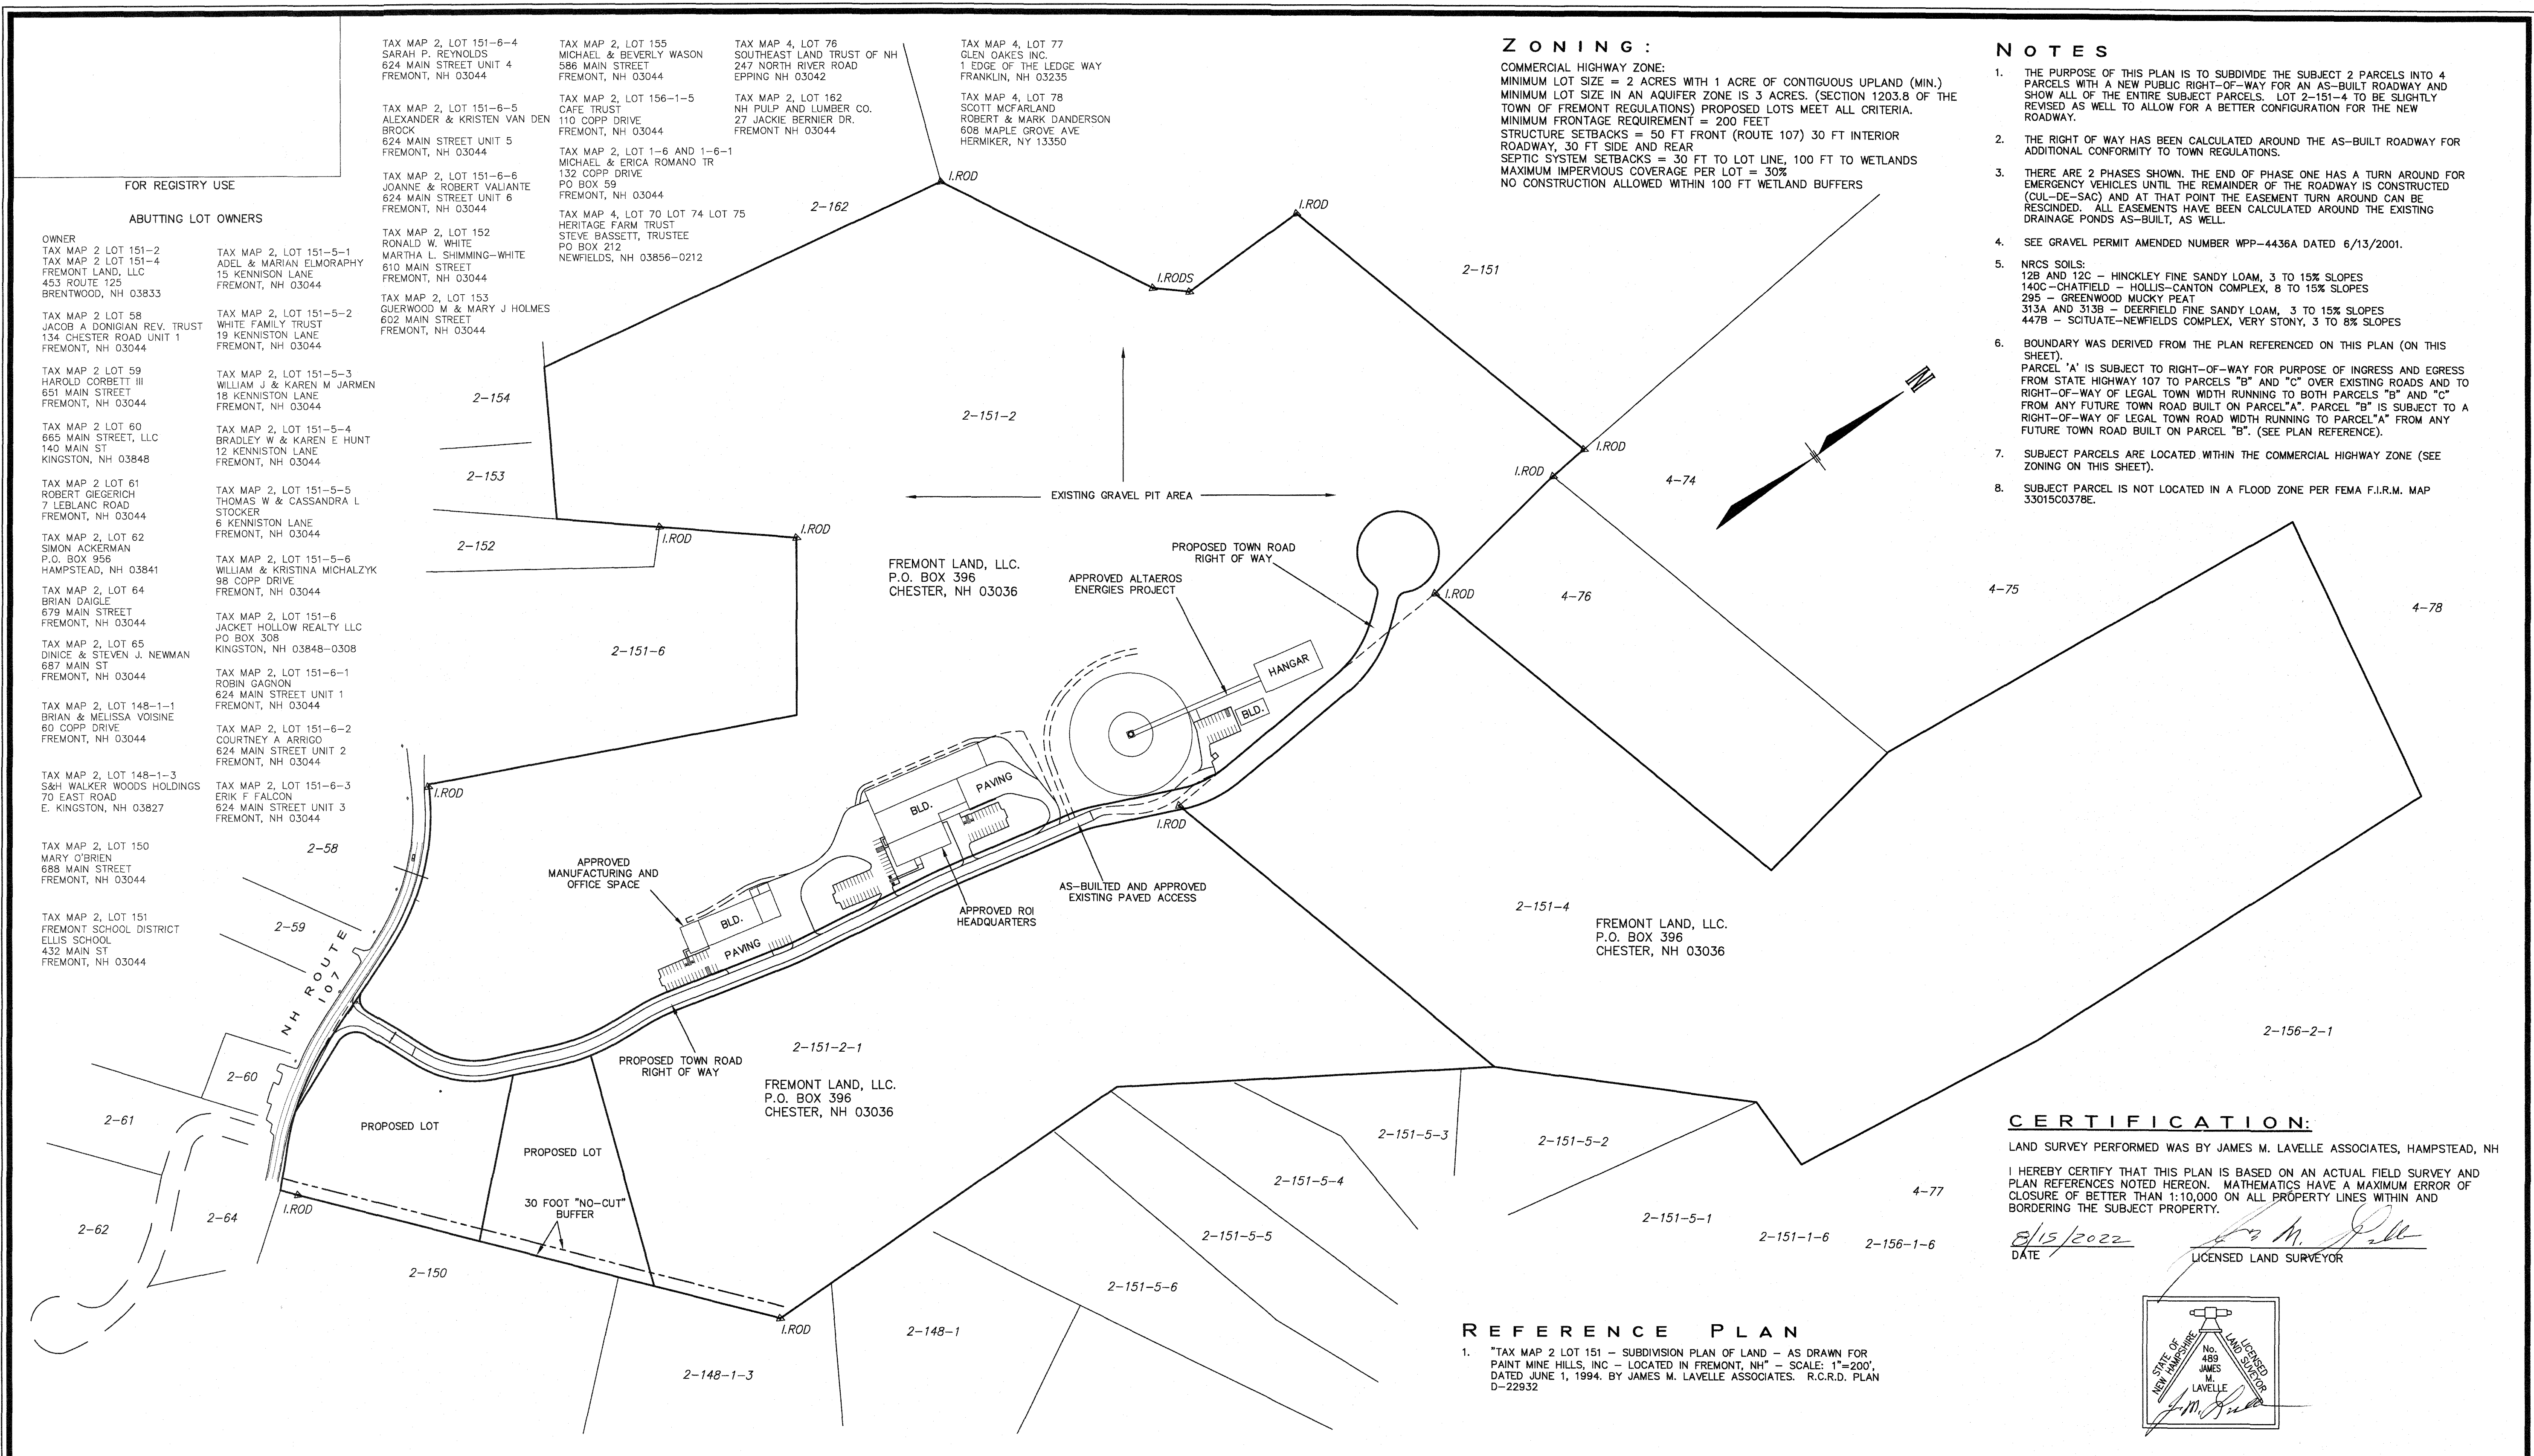



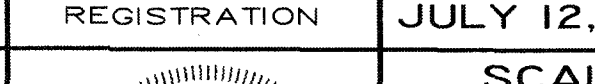
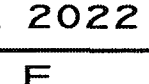
ZONING:
COMMERCIAL HIGHWAY ZONE:
MINIMUM LOT SIZE = 2 ACRES WITH 1 ACRE OF CONTIGUOUS UPLAND (MIN.)
MINIMUM LOT SIZE IN AN AQUIFER ZONE IS 3 ACRES. (SECTION 1203.8 OF THE
TOWN OF FREMONT REGULATIONS) PROPOSED LOTS MEET ALL CRITERIA.
MINIMUM FRONTAGE REQUIREMENT = 200 FEET
STRUCTURE SETBACKS = 50 FT FRONT (ROUTE 107) 30 FT INTERIOR
ROADWAY, 30 FT SIDE AND REAR
SEPTIC SYSTEM SETBACKS = 30 FT TO LOT LINE, 100 FT TO WETLANDS
MAXIMUM IMPERVIOUS COVERAGE PER LOT = 30%
NO CONSTRUCTION ALLOWED WITHIN 100 FT WETLAND BUFFERS


- NOTES**
1. THE PURPOSE OF THIS PLAN IS TO SUBDIVIDE THE SUBJECT 2 PARCELS INTO 4 PARCELS WITH A NEW PUBLIC RIGHT-OF-WAY FOR AN AS-BUILT ROADWAY AND SHOW ALL OF THE ENTIRE SUBJECT PARCELS. LOT 2-151-4 TO BE SLIGHTLY REVISED AS WELL TO ALLOW FOR A BETTER CONFIGURATION FOR THE NEW ROADWAY.
 2. THE RIGHT OF WAY HAS BEEN CALCULATED AROUND THE AS-BUILT ROADWAY FOR ADDITIONAL CONFORMITY TO TOWN REGULATIONS.
 3. THERE ARE 2 PHASES SHOWN. THE END OF PHASE ONE HAS A TURN AROUND FOR EMERGENCY VEHICLES UNTIL THE REMAINDER OF THE ROADWAY IS CONSTRUCTED (CUL-DE-SAC) AND AT THAT POINT THE EASEMENT TURN AROUND CAN BE RESCINDED. ALL EASEMENTS HAVE BEEN CALCULATED AROUND THE EXISTING DRAINAGE PONDS AS-BUILT, AS WELL.
 4. SEE GRAVEL PERMIT AMENDED NUMBER WPP-4436A DATED 6/13/2001.
 5. NRCS SOILS:
12B AND 12C - HINCKLEY FINE SANDY LOAM, 3 TO 15% SLOPES
140C-CHATFIELD - HOLLIS-CANTON COMPLEX, 8 TO 15% SLOPES
295 - GREENWOOD MUCKY PEAT
313A AND 313B - DEERFIELD FINE SANDY LOAM, 3 TO 15% SLOPES
447B - SCITUATE-NEWFIELDS COMPLEX, VERY STONY, 3 TO 8% SLOPES
 6. BOUNDARY WAS DERIVED FROM THE PLAN REFERENCED ON THIS PLAN (ON THIS SHEET).
PARCEL 'A' IS SUBJECT TO RIGHT-OF-WAY FOR PURPOSE OF INGRESS AND EGRESS FROM STATE HIGHWAY 107 TO PARCELS 'B' AND 'C' OVER EXISTING ROADS AND TO RIGHT-OF-WAY OF LEGAL TOWN WIDTH RUNNING TO BOTH PARCELS 'B' AND 'C' FROM ANY FUTURE TOWN ROAD BUILT ON PARCEL 'A'. PARCEL 'B' IS SUBJECT TO A RIGHT-OF-WAY OF LEGAL TOWN ROAD WIDTH RUNNING TO PARCEL 'A' FROM ANY FUTURE TOWN ROAD BUILT ON PARCEL 'B'. (SEE PLAN REFERENCE).
 7. SUBJECT PARCELS ARE LOCATED WITHIN THE COMMERCIAL HIGHWAY ZONE (SEE ZONING ON THIS SHEET).
 8. SUBJECT PARCEL IS NOT LOCATED IN A FLOOD ZONE PER FEMA F.I.R.M. MAP 33015C0378E.

CERTIFICATION:
LAND SURVEY PERFORMED WAS BY JAMES M. LAVELLE ASSOCIATES, HAMPSTEAD, NH
I HEREBY CERTIFY THAT THIS PLAN IS BASED ON AN ACTUAL FIELD SURVEY AND PLAN REFERENCES NOTED HEREON. MATHEMATICS HAVE A MAXIMUM ERROR OF CLOSURE OF BETTER THAN 1:10,000 ON ALL PROPERTY LINES WITHIN AND BORDERING THE SUBJECT PROPERTY.
8/15/2022
DATE
JAMES M. LAVELLE
LICENSED LAND SURVEYOR

REFERENCE PLAN
1. "TAX MAP 2 LOT 151 - SUBDIVISION PLAN OF LAND - AS DRAWN FOR PAINT MINE HILLS, INC. - LOCATED IN FREMONT, NH" - SCALE: 1"=200', DATED JUNE 1, 1994. BY JAMES M. LAVELLE ASSOCIATES. R.C.R.D. PLAN D-22932

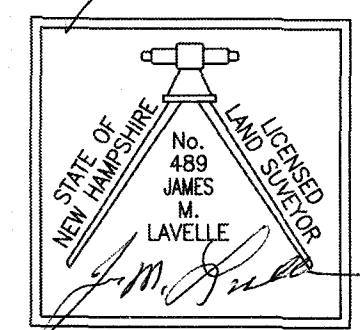

		R E V I S I O N S		OVERALL PLAN		PREPARED FOR: OWNER: FREMONT LAND, LLC. P.O. BOX 396 CHESTER, NH 03036	PREPARED BY DESIGN ENGINEER GREGSAK & SONS, INC.  ENGINEERING, ARCHITECTURE & CONSTRUCTION MANAGEMENT P.O. BOX 271 CHESTER, NEW HAMPSHIRE 03036 PH: (603) 887-6979 WWW.GREGSAK.COM		JULY 12, 2022
		NO.	DESCRIPTION	DATE	TAX MAP 2 - LOT 151-2 & 151-4 IRON HORSE PARK 662 MAIN STREET FREMONT, NEW HAMPSHIRE				
									

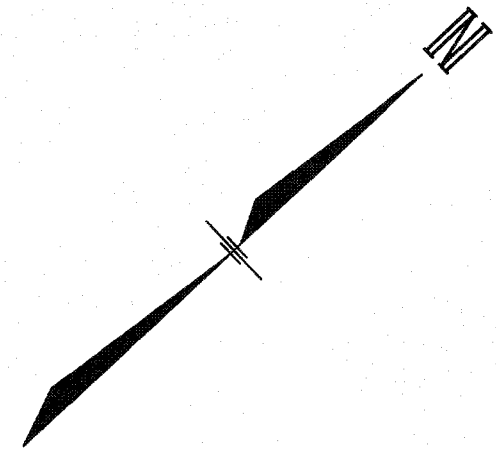


NOTE:
REFER TO COVER SHEET (1) AND OVERALL PLAN (2) FOR ALL
PERTINENT INFORMATION SUCH AS ZONING, TOTAL PROPERTY
BOUNDARY, ABUTTING PROPERTY OWNERS AND CERTIFICATIONS

SOIL TYPES
12-HINKLEY SANDY SOILS - HSG TYPE A
295-GREENWOOD-VERY POORLY DRAINED-CLASS VI
313-DEERFIELD SANDY AND GRAVELLY SOILS -HSG TYPE B
546-WALPOLE-POORLY DRAINED-CLASS V WETLANDS

TEST PITS
AUGUST 8, 2022
IRON HORSE PARK, FREMONT, NH
SUNNY - 80
PERFORMED BY WILLIAM GRECSAK, PE
INSPECTED BY LAURENCE MINER
TP-2
0"-6" SANDY LOAM 10YR 3/2
6"-40" LOAMY SAND W/STONES 10YR 5/4
REFUSAL - 40"
ESHWI - 36"
ROOTS - 36"
H2O- NONE OBSERVED
PERC 4 MIN/IN
TP-3
0"-6" SANDY LOAM 10YR 3/2
6"-48" LOAMY SAND W/STONES 10YR 5/4
REFUSAL - 48"
ESHWI - 36"
ROOTS - 36"
H2O N- NONE OBSERVED
PERC 4 MIN/IN

CERTIFICATION:
LAND SURVEY PERFORMED WAS BY JAMES M. LAVELLE ASSOCIATES, HAMPSTEAD, NH
I HEREBY CERTIFY THAT THIS PLAN IS BASED ON AN ACTUAL FIELD SURVEY AND
PLAN REFERENCES NOTED HEREON. MATHEMATICS HAVE A MAXIMUM ERROR OF
CLOSURE OF BETTER THAN 1:10,000 ON ALL PROPERTY LINES WITHIN AND
BORDERING THE SUBJECT PROPERTY.
DATE 8/9/2022
LAVELLE
LICENSED LAND SURVEYOR

REVISIONS			LAND SUBDIVISION EXISTING CONDITIONS		PREPARED FOR:		PREPARED BY DESIGN ENGINEER		REGISTRATION		JULY 12, 2022	
NO.	DESCRIPTION	DATE	TAX MAP 2 - LOT 151-2 & 151-4		OWNER:		DESIGNER		JAMES M. LAVELLE		SCALE	
			IRON HORSE PARK		FREMONT LAND, LLC.		GREGSAK & SONS, INC.		P.O. BOX 271		1"=100'	
			662 MAIN STREET		P.O. BOX 396		ENGINEERING, ARCHITECTURE		CHESTER, NEW HAMPSHIRE 03036		SHEET 3	
			FREMONT, NEW HAMPSHIRE		CHESTER, NH 03036		& CONSTRUCTION MANAGEMENT		PH: (603) 887-6979		OF 7	
							P.O. BOX 271		WWW.GREGSAK.COM		JOB # 3160	

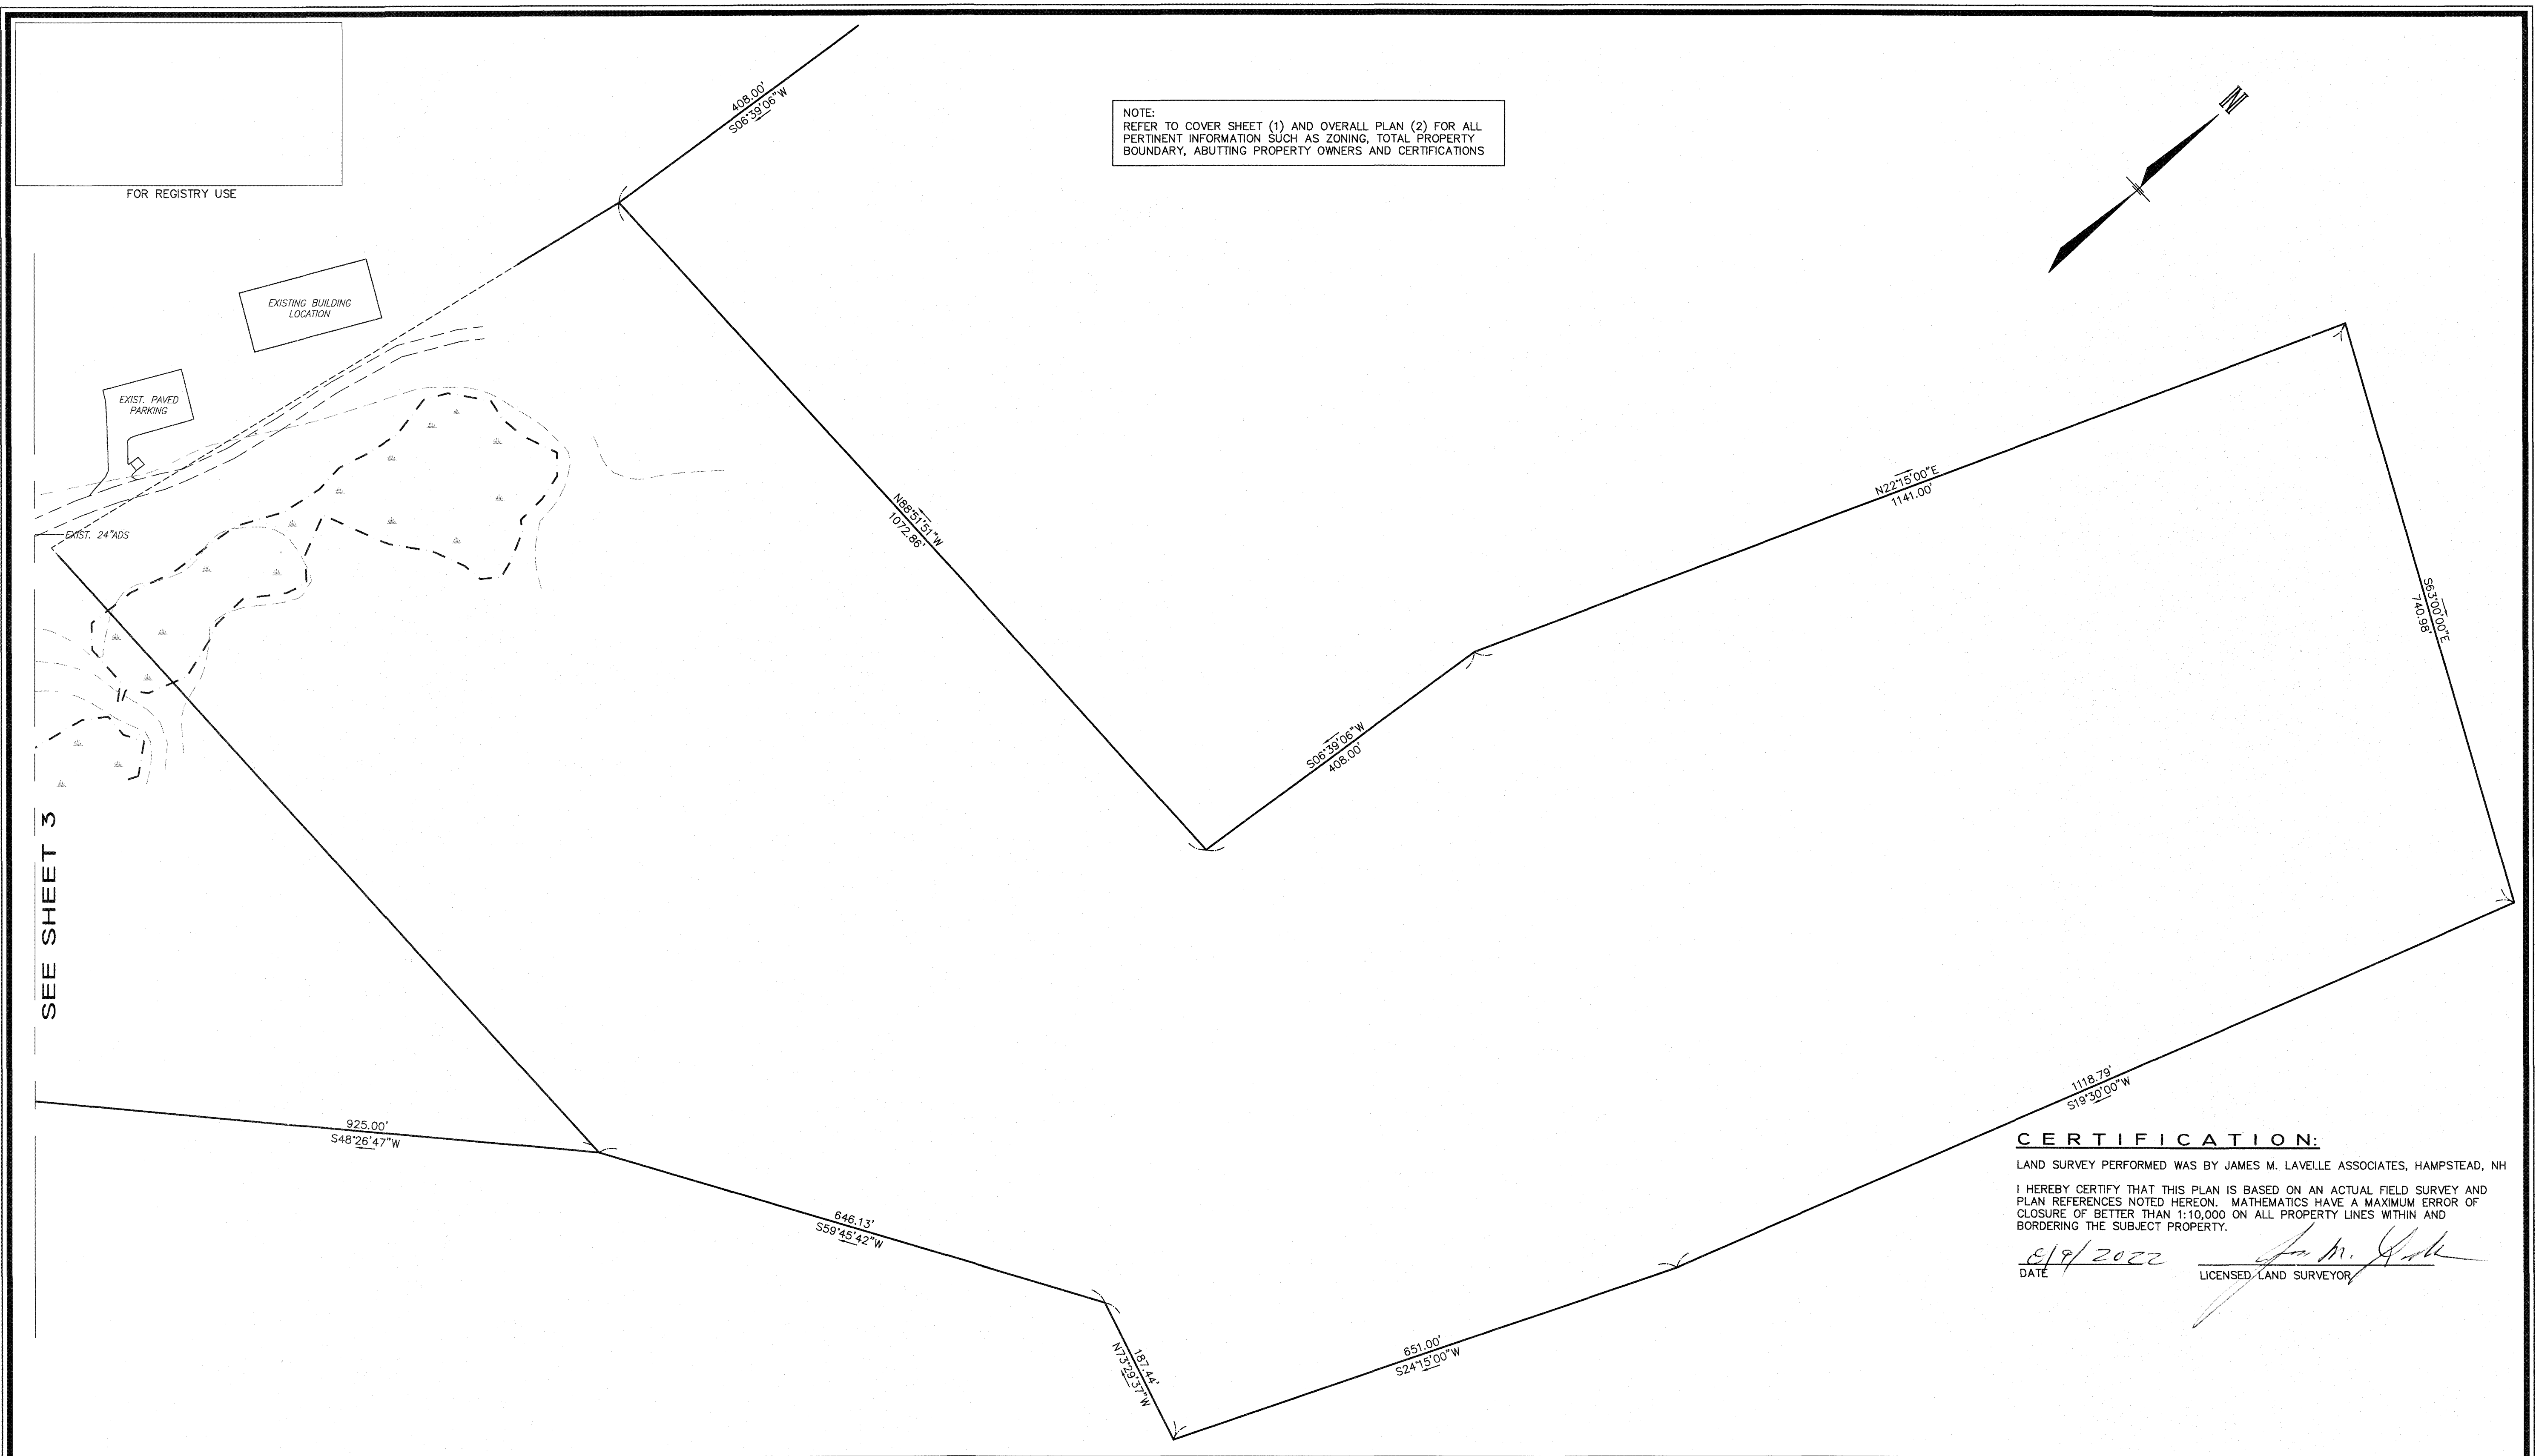

CERTIFICATION:
LAND SURVEY PERFORMED WAS BY JAMES M. LAVELLE ASSOCIATES, HAMPSTEAD, NH
I HEREBY CERTIFY THAT THIS PLAN IS BASED ON AN ACTUAL FIELD SURVEY AND
PLAN REFERENCES NOTED HEREON. MATHEMATICS HAVE A MAXIMUM ERROR OF
CLOSURE OF BETTER THAN 1:10,000 ON ALL PROPERTY LINES WITHIN AND
BORDERING THE SUBJECT PROPERTY.
DATE 8/9/2022 James M. Lavelle
LICENSED LAND SURVEYOR

		REVISIONS		LAND SUBDIVISION EXISTING CONDITIONS		PREPARED FOR: OWNER: FREMONT LAND, LLC. P.O. BOX 396 CHESTER, NH 03036	PREPARED BY DESIGN ENGINEER GREGSAK & SONS, INC. ENGINEERING, ARCHITECTURE & CONSTRUCTION MANAGEMENT P.O. BOX 271 CHESTER, NEW HAMPSHIRE 03036 PH: (603) 887-6979 WWW.GREGSAK.COM	REGISTRATION 	JULY 12, 2022 SCALE 1"=100' SHEET 4 OF 7 JOB # 3160
		NO.	DESCRIPTION	DATE	TAX MAP 2 - LOT 151-2 & 151-4 IRON HORSE PARK 662 MAIN STREET FREMONT, NEW HAMPSHIRE				

Journal of Management Education 30(6)p. 789-804
© The Author(s) 2006
Reprints and permissions:
<http://www.sagepub.com/journalsPermissions.nav>

1. PLAN REFERENCE FOR ALL EXISTING PROPERTY BOUNDARY INFORMATION:
"TAX MAP 2 LOT 151 - SUBDIVISION PLAN OF LAND - AS DRAWN FOR - PAINT
MINE HILLS, INC. - LOCATED IN FREMONT, NH", SCALE 1 INCH=200 FEET AND
DATED JUNE 1, 1994 BY JAMES M. LAYELLE ASSOCIATES, HAMPSSTEAD NH. (R.C.R.D.
PLAN D-22932)
2. THIS PLAN ALSO REPRESENTS AN AS-BUILT SURVEY OF THE NEW ROADWAY AND
SUBSEQUENTLY THE NEW PROPOSED PUBLIC ROAD RIGHT OF WAY HAS BEEN
CALCULATED AROUND THAT AS-BUILT FOR ADDITIONAL CONFORMITY TOWN
REGULATIONS.
3. THERE ARE 2 PHASES SHOWN. THE END OF PHASE ONE HAS A TURN AROUND FOR
EMERGENCY VEHICLES UNTIL THE REMAINDER OF THE ROADWAY IS CONSTRUCTED
CUL-DE-SAC. ALL EASEMENTS HAVE BEEN CALCULATED AROUND THE EXISTING
DRAINAGE PONDS AS-BUILT, AS WELL.
4. ZONING:
COMMERCIAL
MINIMUM LOT SIZE 2 ACRES
MINIMUM LOT FRONTAGE 200 FEET
MINIMUM STRUCTURE SETBACKS 30 FEET FROM 15 FEET SIDE AND REAR

NOTE:
REFER TO COVER SHEET (1) AND OVERALL PLAN (2) FOR ALL
PERTINENT INFORMATION SUCH AS ZONING, TOTAL PROPERTY
BOUNDARY, ABUTTING PROPERTY OWNERS AND CERTIFICATIONS

TEST PITS
AUGUST 8, 2022

IRON HORSE PARK, FREMONT, NH

SUNNY - 80
PERFORMED BY WILLIAM GRECSAK, PE
INSPECTED BY LAURENCE MINER

TP-2
0"-6" SANDY LOAM 10YR 3/2

6"-40" LOAMY SAND W/STONES 10YR 5/4

REFUSAL - 40"
ESHW - 36"
ROOTS - 36"
H2O - NONE OBSERVED
PERC 4 MIN/IN

TP-3
0"-6" SANDY LOAM 10YR 3/2

6"-48" LOAMY SAND W/STONES 10YR 5/4

REFUSAL - 48"
ESHW - 36"
ROOTS - 36"
H2O N- NONE OBSERVED
PERC 4 MIN/IN

LAND SURVEY PERFORMED WAS BY JAMES M. LAVELLE ASSOCIATES, HAMPSTEAD, NH

I HEREBY CERTIFY THAT THIS PLAN IS BASED ON AN ACTUAL FIELD SURVEY AND
PLAN REFERENCES NOTED HEREON. MATHEMATICS HAVE A MAXIMUM ERROR OF
CLOSURE OF BETTER THAN 1:10,000 ON ALL PROPERTY LINES WITHIN AND
BORDERING THE SUBJECT PROPERTY.

DATE 8/9/2022 J. M. Rath
DATE _____ LICENSED LAND SURVEYOR _____

[illegible]

LAND SUBDIVISION

TAX MAP 2 - LOT 151-2 & 151-4

IRON HORSE PARK
662 MAIN STREET
FREMONT, NEW HAMPSHIRE


PREPARED FOR:
OWNER:

FREMONT LAND, LLC.
P.O. BOX 396
CHESTER, NH 03036


PREPARED BY DESIGN ENGINEER

GREGSAK & SONS, INC.

*ENGINEERING, ARCHITECTURE
& CONSTRUCTION MANAGEMENT*




P.O. BOX 271
CHESTER, NEW HAMPSHIRE 03036
PH: (603) 887-6979
WWW.GREGSAK.COM

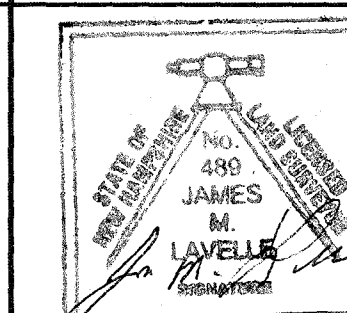

JULY 12, 2022

SCALE


50 0 100



1"=100'

SHEET 5 OF 7

JOB # 3160

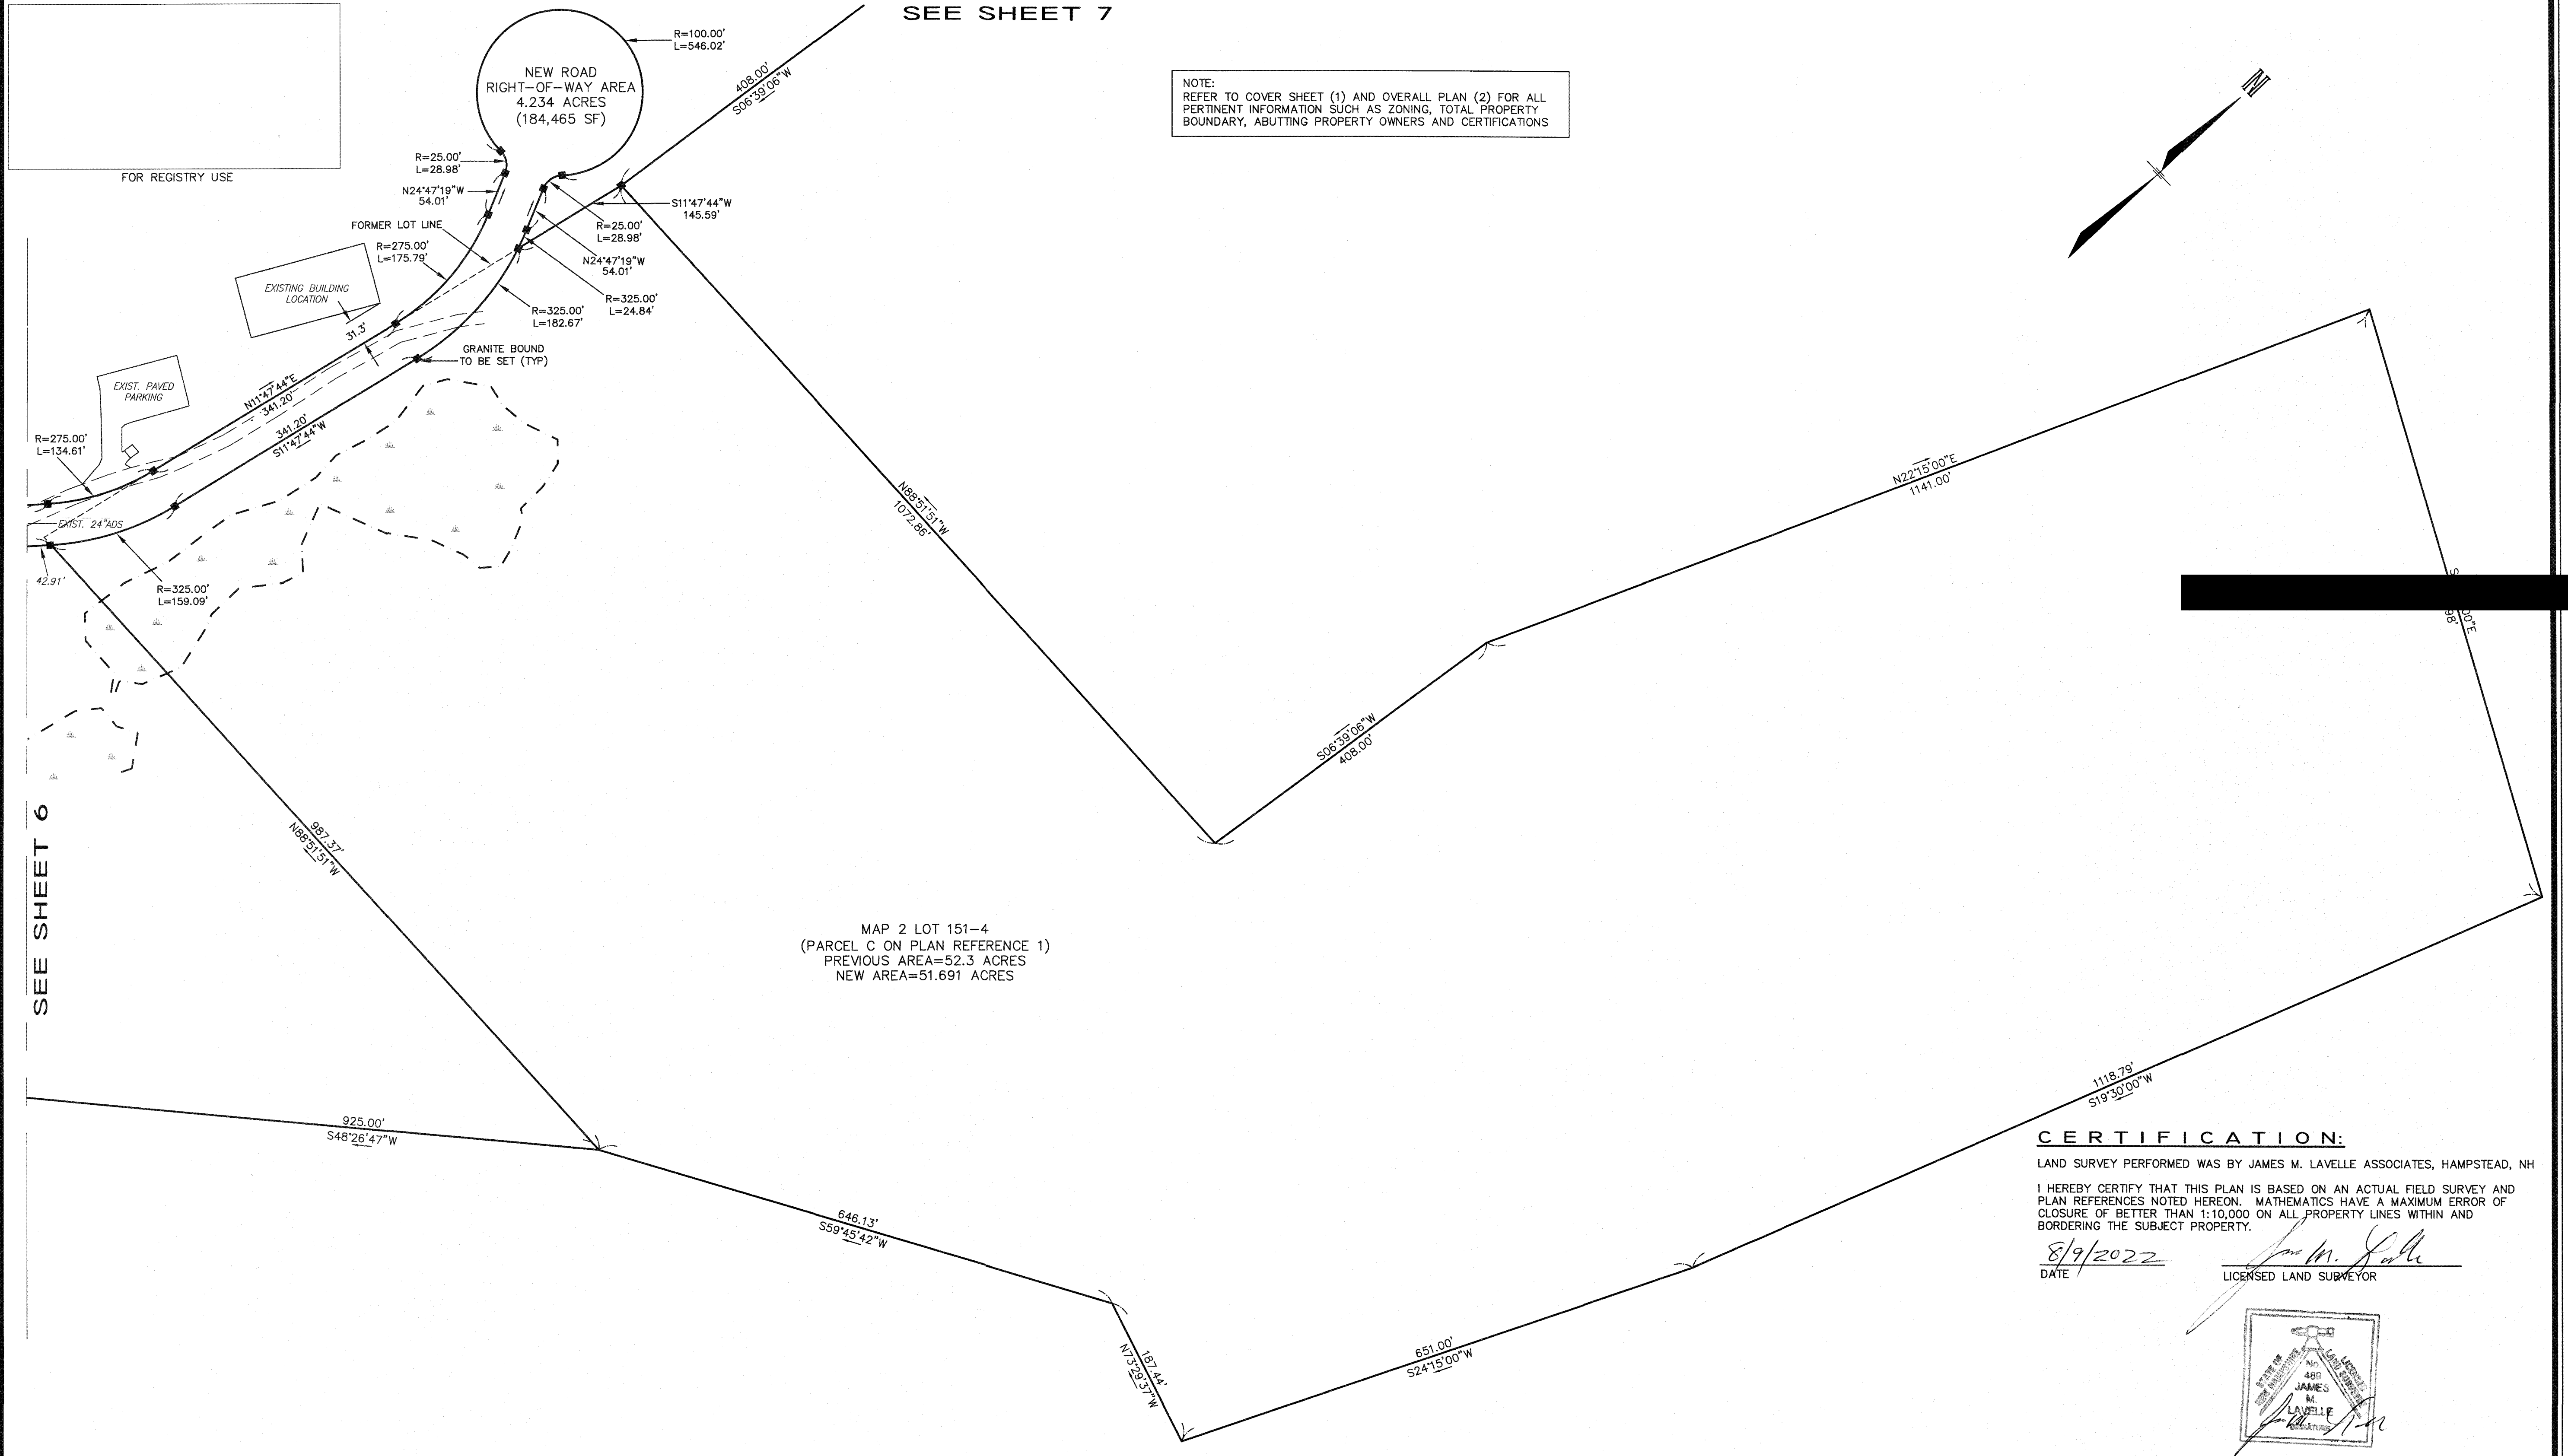


SEE SHEET 6


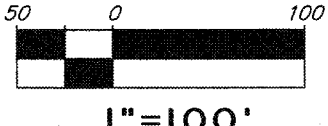
SEE SHEET 7

NOTE:
REFER TO COVER SHEET (1) AND OVERALL PLAN (2) FOR ALL
PERTINENT INFORMATION SUCH AS ZONING, TOTAL PROPERTY
BOUNDARY, ABUTTING PROPERTY OWNERS AND CERTIFICATIONS


MAP 2 LOT 151-4
(PARCEL C ON PLAN REFERENCE 1)
PREVIOUS AREA=52.3 ACRES
NEW AREA=51.691 ACRES

CERTIFICATION:
LAND SURVEY PERFORMED WAS BY JAMES M. LAVELLE ASSOCIATES, HAMPSTEAD, NH
I HEREBY CERTIFY THAT THIS PLAN IS BASED ON AN ACTUAL FIELD SURVEY AND
PLAN REFERENCES NOTED HEREON. MATHEMATICS HAVE A MAXIMUM ERROR OF
CLOSURE OF BETTER THAN 1:10,000 ON ALL PROPERTY LINES WITHIN AND
BORDERING THE SUBJECT PROPERTY.
8/9/2022
DATE
JAMES M. LAVELLE
LICENSED LAND SURVEYOR

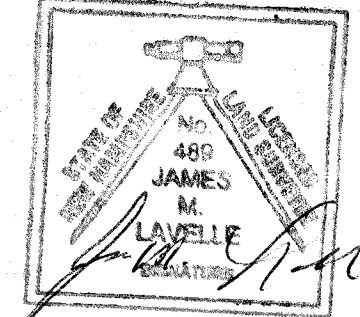

REVISIONS			LAND SUBDIVISION		PREPARED FOR:	PREPARED BY DESIGN ENGINEER	REGISTRATION	JULY 12, 2022
NO.	DESCRIPTION	DATE	TAX MAP 2 - LOT 151-2 & 151-4 IRON HORSE PARK 662 MAIN STREET FREMONT, NEW HAMPSHIRE		OWNER: FREMONT LAND, LLC. P.O. BOX 396 CHESTER, NH 03036	 GREPSAK & SONS, INC. ENGINEERING, ARCHITECTURE & CONSTRUCTION MANAGEMENT P.O. BOX 271 CHESTER, NEW HAMPSHIRE 03036 PH: (603) 887-6979 WWW.GREPSAK.COM	 SCALE 1"=100' SHEET 6 OF 7 JOB # 3160	

the 1990s, the number of people in the United States who are 65 years of age and older has increased by 50 percent, and the number of people 75 years of age and older has increased by 100 percent. The number of people 85 years of age and older has increased by 200 percent. The number of people 95 years of age and older has increased by 400 percent. The number of people 100 years of age and older has increased by 1,000 percent. The number of people 105 years of age and older has increased by 2,000 percent. The number of people 110 years of age and older has increased by 4,000 percent. The number of people 115 years of age and older has increased by 8,000 percent. The number of people 120 years of age and older has increased by 16,000 percent. The number of people 125 years of age and older has has increased by 16,777,216,000 percent. The number of people 225 years of age and older has increased by 33,554,432,000 percent. The number of people 230 years of age and older has increased by 67,108,864,000 percent. The number of people 235 years of age and older has increased by 134,217,728,000 percent. The number of people 240 years of age and older has increased by 268,435,456,000 percent. The number of people 245 years of age and older has increased by 536,870,912,000 percent. The number of people 250 years of age and older has increased by 1,073,741,824,000 percent. The number of people 255 years of age and older has increased by 2,147,483,648,000 percent. The number of people 260 years of age and older has increased by 4,294,967,296,000 percent. The number of people 265 years of age and older has increased by 8,589,934,592,000 percent. The number of people 270 years of age and older has increased by 17,179,869,184,000 percent. The number of people 275 years of age and older has increased by 34,359,738,368,000 percent. The number of people 280 years of age and older has increased by 68,719,476,736,000 percent. The number of people 285 years of age and older has increased by 137,438,953,472,000 percent. The number of people 290 years of age and older has increased by 274,877,906,944,000 percent. The number of people 295 years of age and older has increased by 549,755,813,888,000 percent. The number of people 300 years of age and older has increased by 1,099,511,627,776,000 percent. The number of people 305 years of age and older has increased by 2,199,023,255,552,000 percent. The number of people 310 years of age and older has increased by 4,398,046,511,104,000 percent. The number of people 315 years of age and older has increased by 8,796,093,022,208,000 percent. The number of people 320 years of age and older has increased by 17,592,186,044,416,000 percent. The number of people 325 years of age and older has increased by 35,184,372,088,832,000 percent. The number of people 330 years of age and older has increased by 70,368,744,177,664,000 percent. The number of people 335 years of age and older has increased by 140,737,488,355,328,000 percent. The number of people 340 years of age and older has increased by 281,474,976,710,656,000 percent. The number of people 345 years of age and older has increased by 562,949,953,421,312,000 percent. The number of people 350 years of age and older has increased by 1,125,899,906,842,624,000 percent. The number of people 355 years of age and older has increased by 2,251,799,813,685,248,000 percent. The number of people 360 years of age and older has increased by 4,503,599,627,370,496,000 percent. The number of people 365 years of age and older has increased by 9,007,199,254,740,992,000 percent. The number of people 370 years of age and older has increased by 18,014,398,509,481,984,000 percent. The number of people 375 years of age and older has increased by 36,028,797,018,963,968,000 percent. The number of people 380 years of age and older has increased by 72,057,594,037,927,936,000 percent. The number of people 385 years of age and older has increased by 144,115,188,075,855,872,000 percent. The number of people 390 years of age and older has increased by 288,230,376,151,711,744,000 percent. The number of people 395 years of age and older has increased by 576,460,752,303,423,488,000 percent. The number of people 400 years of age and older has increased by 1,152,921,504,606,846,976,000 percent. The number of people 405 years of age and older has increased by 2,305,843,009,213,693,952,000 percent. The number of people 410 years of age and older has increased by 4,611,686,018,427,387,904,000 percent. The number of people 415 years of age and older has increased by 9,223,372,036,854,775,808,000 percent. The number of people 420 years of age and older has increased by 18,446,744,073,709,551,616,000 percent. The number of people 425 years of age and older has increased by 36,893,488,147,419,103,232,000 percent. The number of people 430 years of age and older has increased by 73,786,976,294,838,206,464,000 percent. The number of people 435 years of age and older has increased by 147,573,952,589,676,412,928,000 percent. The number of people 440 years of age and older has increased by 295,147,905,179,352,825,856,000 percent. The number of people 445 years of age and older has increased by 590,295,810,358,705,651,712,000 percent. The number of people 450 years of age and older has increased by 1,180,591,620,717,411,303,424,000 percent. The number of people 455 years of age and older has increased by 2,361,183,241,434,822,606,848,000 percent. The number of people 460 years of age and older has increased by 4,722,366,482,869,645,213,696,000 percent. The number of people 465 years of age and older has increased by 9,444,732,965,739,290,427,392,000 percent. The number of people 470 years of age and older has increased by 18,889,465,931,478,580,854,784,000 percent. The number of people 475 years of age and older has increased by 37,778,931,862,957,161,709,568,000 percent. The number of people 480 years of age and older has increased by 75,557,863,725,914,323,419,136,000 percent. The number of people 485 years of age and older has increased by 151,115,727,451,828,646,838,272,000 percent. The number of people 490 years of age and older has increased by 302,231,454,903,657,293,676,544,000 percent. The number of people 495 years of age and older has increased by 604,462,909,807,314,587,353,088,000 percent. The number of people 500 years of age and older has increased by 1,208,925,819,614,629,174,706,176,000 percent. The number of people 505 years of age and older has increased by 2,417,851,639,229,258,349,412,352,000 percent. The number of people 510 years of age and older has increased by 4,835,703,278,458,516,698,824,704,000 percent. The number of people 515 years of age and older has increased by 9,671,406,556,917,033,397,649,408,000 percent. The number of people 520 years of age and older has increased by 19,342,813,113,834,066,795,298,816,000 percent. The number of people 525 years of age and older has increased by 38,685,626,227,668,133,590,597,632,000 percent. The number of people 530 years of age and older has increased by 77,371,252,455,336,267,181,195,264,000 percent. The number of people 535 years of age and older has increased by 154,742,504,910,672,534,362,390,528,000 percent. The number of people 540 years of age and older has increased by 309,485,009,821,345,068,724,781,056,000 percent. The number of people 545 years of age and older has increased by 618,970,019,642,690,137,449,562,112,000 percent. The number of people 550 years of age and older has increased by 1,237,940,039,285,380,274,899,124,224,000 percent. The number of people 555 years of age and older has increased by 2,475,880,078,570,760,549,798,248,448,000 percent. The number of people 560 years of age and older has increased by 4,951,760,157,141,521,099,596,496,896,000 percent. The number of people 565 years of age and older has increased by 9,903,520,314,283,042,199,193,993,792,000 percent. The number of people 570 years of age and older has increased by 19,807,040,628,566,084,398,387,987,584,000 percent. The number of people 575 years of age and older has

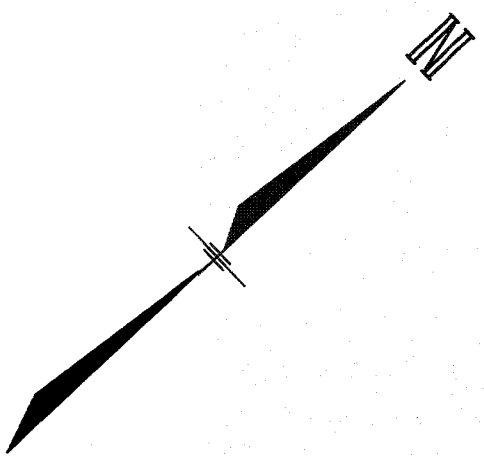


SEE SHEET 6



LAND SURVEY PERFORMED WAS BY JAMES M. LAVELLE ASSOCIATES, HAMPSTEAD, NH

DATE 8/9/2022

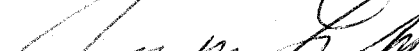PROPERTY.



LICENSED LAND SURVEYOR

NOTE:
REFER TO COVER SHEET (1) AND OVERALL PLAN (2) FOR ALL
PERTINENT INFORMATION SUCH AS ZONING, TOTAL PROPERTY
BOUNDARY, ABUTTING PROPERTY OWNERS AND CERTIFICATIONS

LAND SUBDIVISION

TAX MAP 2 - LOT 151-2 & 151-4

IRON HORSE PARK


662 MAIN STREET

FREMONT, NEW HAMPSHIRE

PREPARED BY DESIGN ENGINEER

GREGSAK & SONS, INC.

*ENGINEERING, ARCHITECTURE
& CONSTRUCTION MANAGEMENT*




P.O. BOX 271
CHESTER, NEW HAMPSHIRE 03036
PH: (603) 887-6979
WWW.GREGSAK.COM

JULY 12, 2022

SCALE

50 0 100



1"=100'

SHEET 7

OF 7

JOB # 3160